AMENDMENT OF SOLICITATION/N	10DIFICATION	OF CONTRACT	1. C0	ONTRACT ID COD	DE	PAGE O	F PAGES 5
2. AMENDMENT/MODIFICAITON NO. 3 AMENDMENT NO. 0005	B. EFFECTIVE DATE 09/12/12	4. REQUISITION/PURCH	ASE REC	Q. NO.	5. PROJECT 1		-
6. ISSUED BY CODE	eaw	7. ADMINISTERED BY (If	f other t	han Item 6)	CODE		
Officer in Charge of Construction 1005 Michael Road Camp Lejeune, NC 28547-2521	n MCI-East		See	e Item 6			
8. NAME AND ADDRESS OF CONTRACTOR (No., street, count	y, State and ZIP Code)		(X)	9A. AMENDMENT	OF SOLICIA	FION NO.	
			×		5-11-R-C	207	
			2	9B. DATED (SEE I 08/09			
				10A. MODIFICAT	1	RACT/ORDE	R NO.
				10B. DATED (SEE	ITEM 11)		
	LITY CODE						
11. THIS ITEM	ONLY APPLIES TO	AMENDMENTS OF	SOLIC	CITATIONS			
Offers must acknowledge receipt of this amendment prior to the (a)By completing items 8 and 15, and returning co or (c) By separate letter or telegram which includes a reference PLACE DESIGNATED FOR THE RECEIPT OF OFFERS PRIOR TO your desire to change an offer already submitted, such change amendment, and is received prior to the opening hour and date 12. ACCOUNTING AND APPROPIRATION DATA (If required)	pies of the amendment; (I to the solicitation and am THE HOUR AND DATE S may be made by telegram	 b) By acknowledging receipt endment numbers. FAILURI PECIFIED MAY RESULT IN F 	of this E OF YO REJECTI	amendment on ea DUR ACKNOWLED ON OF YOUR OFF	GMENT TO B ER. If by virt	E RECEIVED ue of this an	AT THE nendment
		DIFICATION OF CO			2		
		DER NO. AS DESCRI			5.		
CHECK ONE A. THIS CHANGE ORDER IS ISSUED PURSUA NO. IN ITEM 10A.	NT TO: (Specify authorit)) THE CHANGES SET FORT	'H IN ITE	EM 14 ARE MADE	IN THE CON	TRACT ORD	ER
appropriation date, etc.) SET FORTH IN IT	EM 14, PURSUANT TO T	HE AUTHORITY OF FAR 43	TIVE CHANGES (such as changes in paying office, 8 43.103(b).				
C. THIS SUPPLEMENTAL AGREEMENT IS EN		TO AUTHORITY OF:					
D. OTHER (Specify type of modification and a	authority)						
E. IMPORTANT: Contractor 🗶 is not, 🗌 is	required to sign th	is document and retu	urn —	cop	pies to the	issuing c	office.
14. DESCRIPTION OF AMENDMENT/MODIFICATION (Organize 11-0207, Repair Flight Simulator		-	ract sub	ject matter where	e feasible.)		
Proposals received at 1500 hours are hereby incorporated in accord			y car	ncelled.	Revisio	ns to t	the RFP
	See Contin	uation Page					
Except as provided herein, all terms and conditions of the docu	ment referenced in Item 9		-				xt.
15A. NAME AND TITLE OF SIGNER (Type or print)		16A. NAME AND TITLE OF	CONTF	RACTING OFFICE	R (Type or prir	nt)	
15B. CONTRACTOR/OFFEROR	15C. DATE SIGNED	16B. UNITED STATES OF A	AMERIC	CA		16C. DA	TE SIGNED
(Signature of person authorized to sign)	-	(Signatur	e of Cor	ntracting Officer)		-	
-	1			07.11			

Continuation Page


1. The date and time for receipt of revised proposals is hereby extended to 0900 on 14 September 2012.

2. The attached revised E-1 and E-4 sheets include Shunt Trip Breakers on the panels serving the simulator equipment and related computers and controllers (See clouded areas for changes). E-1: Equipment Connection Schedule - Conductor sizes for item 1, 6, & 7 have changed. FP-4: see clouded areas for changes.

GENERAL	SYMBOLS
SYMBOL	DESCRIPTION
	CONDUIT RUN CONCEALED ABOVE CEILINGS OR IN WALLS.
	CONDUIT RUN CONCEALED IN OR BELOW FLOORS OR UNDERGROUND.
··_	CONDUIT RUN EXPOSED.
o	CONDUIT TURNING UP
•	CONDUIT TURNING DOWN
	SQUARE ON CONDUIT SYMBOL INDICATES THAT CIRCUIT CONTINUES BUT NOT SW HOMERUN TO PANEL AND CIRCUIT(S) DESIGNATED. ARROW(S) INDICATE QUANTITY
J	JUNCTION BOX PER N.E.C.
$\langle 1 \rangle$	SPECIAL NOTE, NUMERALS IDENTIFY, SEE SCHEDULE.
	SPECIAL CONNECTION TO A SPECIFIC ITEM OF EQUIPMENT. SEE CONNECTION SCH
Ø	MOTOR CONNECTION. RATING AS NOTED.
LIGHTING	
SYMBOL	DESCRIPTION
0	FLUORESCENT LIGHTING FIXTURE, DRAWN TO SCALE.
•	FLUORESCENT LIGHTING FIXTURE, CONNECTED TO AN EMERGENCY CIRCUIT (SWITC
	FLUORESCENT LIGHTING FIXTURE, UTILIZED AS A NIGHT-LIGHT. CONNECT TO THE LEG OF THE CIRCUIT.
	FLUORESCENT LIGHTING FIXTURE, CONNECTED TO AN EMERGENCY CIRCUIT, CONNUNSWITCHED LEG OF THE CIRCUIT.
	BARE FLUORESCENT STRIP FIXTURE.
	BARE FLUORESCENT STRIP FIXTURE CONNECTED TO AN EMERGENCY CIRCUIT. CONTHE UNSWITCHED LEG OF THE CIRCUIT.
0	INCANDESCENT, HID OR COMPACT FLUORESCENT LIGHTING FIXTURE, CEILING MOUI
٠	INCANDESCENT, HID OR COMPACT FLUORESCENT LIGHTING FIXTURE, CONNECTED EMERGENCY CIRCUIT OR EMERGENCY BALLAST.
ю	INCANDESCENT, HID OR COMPACT FLUORESCENT LIGHTING FIXTURE, WALL MOUNT
H	INCANDESCENT, HID OR COMPACT FLUORESCENT LIGHTING FIXTURE, WALL MOUNT CONNECTED TO AN EMERGENCY CIRCUIT OR EMERGENCY BALLAST.
\bigotimes	EXIT SIGN, CEILING MOUNTED. SHADING INDICATES FACE ORIENTATION. PROVIDE CONNECT TO THE UNSWITCHED LEG OF THE CIRCUIT.
-3	EXIT SIGN, WALL MOUNTED. SHADING INDICATES FACE ORIENTATION. BESIDE CONNECT TO THE UNSWITCHED LEG OF THE CIRCUIT.
•==•	EMERGENCY BATTERY PACK FIXTURE, CEILING MOUNTED. CONNECT TO UNSWITCHING THE CIRCUIT.
H	EMERGENCY BATTERY PACK FIXTURE, WALL MOUNTED. CONNECT TO UNSWITCHED CIRCUIT.
DISTRIBU	TION
SYMBOL	DESCRIPTION
	ELECTRICAL PANELBOARD, FLUSH MOUNTED.
	ELECTRICAL PANELBOARD, SURFACE MOUNTED.
	CONTROL CABINET, FLUSH OR SURFACE MOUNTED.
	MOTOR STARTER
	ENCLOSED CIRCUIT BREAKER
	DISCONNECT SWITCH, NON-FUSIBLE.
	DISCONNECT SWITCH PROVIDED WITH FOLIDMENT
Iı	DISCONNECT SWITCH PROVIDED WITH EQUIPMENT. GROUND CONNECTION.
بر س	COMBINATION MOTOR STARTER AND NON-FUSIBLE DISCONNECT SWITCH.
	COMBINATION MOTOR STARTER AND NON-POSIBLE DISCONNECT SWITCH.
	COMBINATION MOTOR STARTER AND CIRCUIT BREAKER.
	DRY-TYPE TRANSFORMER, 480-120/208V 3-PHASE OR 208-120/208V 3-PHASE


	SYMBOL										SYM. REV	ISED EQUPIMEN		VISIONS
		WIRING D									A SHU	JNT-TRIP REVIS	IONS	
ION		SYMBOL		RIPTION										
N CONCEALED ABOVE CEILINGS OR IN WALLS. N CONCEALED IN OR BELOW FLOORS OR UND N EXPOSED.		=⊖ =⊖ _{Ewc}	DUPLEX F	RECEPTACLE, 125V, 3-WIRE GROUNDING TYP RECEPTACLE, 125V, GROUND FAULT CIRCUIT WITHIN OR BEHIND AN ELECTRIC WATER COC LOCATION.		, 3-WIRE GROUNDING TYPE. ATE WITH PLUMBER FOR	PANELBOARD: PBB SERVICE: 480V 3PH 3W MAINS: 100 AMP MLO LOAD DESCRIPTION WIRE BKR	GROUND BUS TYPE: BRANCH CONNECTED LOAD (KVA)	SC RATING: 25 KAMP MOUNTING: SURFACE ENCLOSURE: NEMA 1 BKR WIRE LOAI	S RMS SYMM.				
RNING UP		- GFI		RECEPTACLE, GROUND FAULT CIRCUIT INTER	RUPTING.		HWP-3 12 15/3 1A	CONNECTED LOAD (KVA) NEUT A B C CM 0.4 0.9 2	KT 2A 15/3 12	HWP-2				
RNING DOWN				GFCI RECEPTACLE. PROVIDE WITH OPERABLE		THERPROOF COVER.	12 / 58 12 / 5C	0.4 0.9 4 0.9 0.4 0.9 6	HB / 12					
CONDUIT SYMBOL INDICATES THAT CIRCUIT C	ONTINUES BUT NOT SWITCHLEG.	⊖c	DUPLEX	RECEPTACLE, 125V, 3-WIRE GROUNDING TYP	E. CEILING MO	UNTED.	HWP-4 12 15/3 7A 12 / 9B	0.4 0.9 8/	3A 15/3 12	HWP-1			~~~~~~~~~~~~~~~~~~~~~~~~~~~~~~~~~~~~~~~	\sim
D PANEL AND CIRCUIT(S) DESIGNATED. ARROW	W(S) INDICATE QUANTITY OF CIRCUITS.			IPLEX RECEPTACLES, 125V, 3-WIRE GROUNDII ANG FACEPLATE.	IG TYPE, IN A	TWO-GANG BOX WITH	12 / 11C CHWP-1 12 15/3 13A	0.9 10 0.4 0.9 12	2C / 12		کم	PH	——— 120V —	
DX PER N.E.C.		Ŕ		PURPOSE RECEPTACLE, WITH SPECIAL NEMA	CONFIGURATI	ON AS NOTED.	12 / 15B	2.1 14 1.3 2.1 16	4A 15/3 12 6B / 12	CHWP-4	کم ک			
TE, NUMERALS IDENTIFY, SEE SCHEDULE.				UTLET FOR TELECOMMUNICATIONS. SEE SPECI T AND CABLING REQUIREMENTS.	FICATIONS AND	OR DRAWINGS FOR	12 / 17C CHWP-2 12 15/3 19A	1.3 2.1 18 1.3 2.1 20		CHWP-3	Å			
NNECTION TO A SPECIFIC ITEM OF EQUIPMENT NECTION. RATING AS NOTED.	. SEE CONNECTION SCHEDULE.	ů 🗳	DOT ABO	OVE OUTLETS INDICATES THAT THE DEVICE IS	5 TO BE INSTA	LLED ABOVE CASEWORK	12 / 21B 12 / 23C	1.3 2.1 2.1 2.2 2.1 2.2	28 / 12		م م	L	∫ ├ ─── † ──	ST _{CB}
		Γ ▼ S		ER OBSTACLE. COORDINATE.			SPACE ONLY /3 25A / 27B	0.0 2.1 24 0.0 26 26 0.0 0.0 26		PACE ONLY		CONTACTS		ST CBO
ION		S3		WITCH, 3-WAY,			/ 29C SPACE ONLY /3 31A		0C /	PACE ONLY	PRE-AC	SUPPRESSION J	↓	ST- _{CBS}
		S4		WITCH, 4-WAY,			/ 33B / 35C		4B /		È			
T LIGHTING FIXTURE, DRAWN TO SCALE.		SS	FLUORES	TWO SWITCHES ARE SHOWN CONTROLLING A SCENT LIGHTING FIXTURES, EACH WITH 3 OR OR SHALL CONTROL THE INNER LAMP(S) IN I	MORE LAMPS,	THE SWITCH CLOSEST TO	SPACE ONLY /3 37A / 39B	0.0 0.0 36 0.0 36 0.0 36	8A /3 S	PACE ONLY	È			ST PAN
T LIGHTING FIXTURE, CONNECTED TO AN EMEI	, , ,		SHALL CO	CONTROL THE OUTER LAMPS IN EACH FIXTUR T WIRING SHALL BE UTILIZED TO ACHIEVE TH	E. WHERE INDIC		/ 41C	0.0 40 0.0 0.0 0.0 9.6 0.0 9.6	2C /		È		• • •	ST PAN
T LIGHTING FIXTURE, UTILIZED AS A NIGHT-L CIRCUIT.		S⊤	PROGRAM	MMABLE LIGHT SWITCH, WALL MOUNTED.			NOTES:	LIG RE MC	GHTS 0.0 KVA ECEPTS 0.0 KVA OTORS 28.8 KVA		<pre>{</pre>	SHUNT TRIP FOR EQUIPM	IENT AS	STPAN
T LIGHTING FIXTURE, CONNECTED TO AN EME LEG OF THE CIRCUIT. ESCENT STRIP FIXTURE.	RGENCY CIRCUIT, CONNECT TO THE	69	ADJUSTM	ANCY SENSOR, CEILING MOUNTED. PROVIDE WI MENT OF LOCATION. COORDINATE EXACT LOC ACTURERS RECOMMENDATION.		HIP TO ALLOW FIELD		HE KIT CM OT TO	EAT 0.0 KVA TCHEN 0.0 KVA MPTR 0.0 KVA THER 0.0 KVA DTAL 28.8 KVA	{	<u></u> SH	IUNT-TF	RIP CO	NTRC
ESCENT STRIP FIXTURE CONNECTED TO AN E CHED LEG OF THE CIRCUIT.	MERGENCY CIRCUIT. CONNECT TO									Ę		TO SCALE		
NT, HID OR COMPACT FLUORESCENT LIGHTING	FIXTURE, CEILING MOUNTED.		<u>ABBR</u>	REVIATIONS										
NT, HID OR COMPACT FLUORESCENT LIGHTING CIRCUIT OR EMERGENCY BALLAST.	FIXTURE, CONNECTED TO AN		A ACC	AMPERES ARMORED CLAD CABLE	KW LFNC	KILOWATTS LIQUIDTIGHT FLEXIBLE NON-METALLIC	CONDUIT							
NT, HID OR COMPACT FLUORESCENT LIGHTING	FIXTURE, WALL MOUNTED.		AFF AFG	ABOVE FINISHED FLOOR ABOVE FINISHED GRADE	LFMC LVC	LIQUIDTIGHT FLEXIBLE METALLIC COND LOW VOLTAGE CONTROL CABINET								
NT, HID OR COMPACT FLUORESCENT LIGHTING TO AN EMERGENCY CIRCUIT OR EMERGENCY I			ANN C CB	FIRE ALARM ANNUNCIATOR CABINET CONDUIT CIRCUIT BREAKER	MCB MCC MLO	MAIN CIRCUIT BREAKER METAL CLAD CABLE MAIN LUGS ONLY	<pre>////////////////////////////////////</pre>	ENCL	OSED_SWIT(CH AND CIRCUIT	BREAKER	SCHEDULE		
EILING MOUNTED. SHADING INDICATES FACE (THE UNSWITCHED LEG OF THE CIRCUIT.	PROVIDE ARROWS AS		CKT CLG	CIRCUIT CEILING	MTD NMC	MOUNTED NON-METALLIC CLAD CABLE						SC RATING	ENCLOSURE	<u> </u>
VALL MOUNTED. SHADING INDICATES FACE ORI	SHOWN ON PLAN BESIDE SYMBOL		DN DW	DOWN DISHWASHER	PB PNL	PULLBOX PANELBOARD	CBA BRIEFING ROOM 2	ТМСЕ		3 225A	200A	10 KAIC	1	
BATTERY PACK FIXTURE, CEILING MOUNTED.	CONNECT TO UNSWITCHED LEG OF		EC EMT	EMPTY CONDUIT ELECTRICAL METALLIC TUBING	PRS PS	PROGRAM RAPID START PROGRAM START	CBCR2 COMPUTER ROOM 2 CBSIM2 SIMULATOR ROOM		· · ·	3 600A 3 400A	600A 300A	10 KAIC 25 KAIC	1	
BATTERY PACK FIXTURE, WALL MOUNTED. CO			ENT EWC FACP	ELECTRICAL NON-METALLIC TUBING ELECTRIC WATER COOLER FIRE ALARM CONTROL PANEL	PWR REC RMC	POWER RECEPTACLE RIGID METAL CONDUIT	(EQUIPM	ENT CONNECTIO		E		
DATIENT FACE TRIONE, WALL MOUNTED. CO	NINEET TO DIVEWITCHED LEG OF THE		FMC	FLEXIBLE METAL CONDUIT GROUND	RS SC	RAPID START FIRE ALARM PULL STATION	SYM. EQUIPM	ENT		VOLT/ PHASE TYPE RATIN		FUSE ENGLU.		RACEV TYPE
			GFI HOA	GROUND FAULT INTERRUPTER HAND OFF AUTOMATIC	SW SWBD	SWITCH SWITCHBOARD	① AHU-1 ② AHU-2			208/3 BUILT I 480/3 NFDS 30A	NTO VFD BY DIVISION		#8, 1#10G #10, 1#10G	FMC FMC
			HP HPF	HORSEPOWER HIGH POWER FACTOR	TTB TEL	TELEPHONE TERMINAL BOARD TELEPHONE	3 CRAC-1,2,3,4			480/3 FDS 30A	3 15		#12, 1#12G	LFMC
PANELBOARD, FLUSH MOUNTED. PANELBOARD, SURFACE MOUNTED.			HX IG	HIGH REACTANCE ISOLATED GROUND	TV TYP	TELEVISION TYPICAL	④ CRAH-1,2,3,4 ⑤ SAH-1,2			480/3 NFDS 100A 208/3 NFDS 60A			#4, 1#8G #8, 1#10G	FMC FMC
BINET, FLUSH OR SURFACE MOUNTED.				INTERMEDIATE METAL CONDUIT INSTANT START JUNCTION BOX	V VP W	VOLTS VAPOR PROOF	6 SAH-3,4 7 CAH-1,2			208/3 NFDS 30A 480/3 NFDS 30A			#10, 1#10G #10, 1#10G	FMC FMC
RTER			JD KVA FPN	KILOVOLT-AMPERES FUSE PER NAMEPLATE	WG WP	WALL MOUNTED WIRE GUARD WEATHER PROOF	8 TEMPORARY A/C UNIT	20		480/3 NFDS 100A			#4, 1#8G	LFMC
IRCUIT BREAKER					XFMR	TRANSFORMER	9 VF-2 10 HWP-1,2			480/3 NFDS 30A 480/3 BUILT INTO	3 VARIABLE FREQUENC		#12, 1#12G #12, 1#12G	FMC FMC
SWITCH, NON-FUSIBLE.							Image: 10 mwp=1,2 Image: 10 mwp=3,4		1.05HP		VARIABLE FREQUENC		#12, 1#12G	FMC
SWITCH, FUSIBLE.							12 CHWP-1,2 13 CHWP-3,4			,	VARIABLE FREQUEN		#12, 1#12G #12, 1#12G	FMC FMC
SWITCH PROVIDED WITH EQUIPMENT.							LEGEND DISCONNECT_TYPES		DISCONNECT ENC		Y TYPES		<u>STARTER T</u> CFVNR = COM	TYPES
N MOTOR STARTER AND NON-FUSIBLE DISCON	INECT SWITCH.						ETCB = ELECTRONIC-TRI FDS = FUSIBLE DISCON MCP = MOTOR CIRCUIT	NECT SWITCH	1 = NEMA 1 E 3R = NEMA 3R	INCLOSURE EMT = ENCLOSURE FMC =	ELECTRIC METALLIC T FLEXIBLE METAL CONI	DUIT	CONTROL D	
N MOTOR STARTER AND FUSIBLE DISCONNECT	SWITCH.						NFDS = NON-FUSIBLE D ST/DS = COMBINATION ST	SCONNECT SWITCH ARTER/DISCONNECT SWITCH		ENCLOSURE LFMC = PVC =	INTERMEDIATE METAL LIQUID-TIGHT FLEXIBL NON-METALLIC PVC (LE METAL CONDUIT	RPL = RED	D PILOT LIGHT XILLARY CONT
N MOTOR STARTER AND CIRCUIT BREAKER.				3#6, 1#10G,	1"C		TMCB = THERMAL-MAGN TOG = HP RATED TOGG		FPN = FUSE PER	NAMEPLATE RMC =	RIGID METAL CONDUIT		C150 = 50	
RANSFORMER, 480-120/208V 3-PHASE OR	208–120/208V 3–PHASE.			EXISTING MOTOR		EXIST				RMATION AVAILABLE AT THE T				
				CONTROL CENTER			GROUNDED. ANY SIGNIFICA ATTENTION OF THE ENGINE	NT CHANGES IN LOCATION, ER IN WRITING PRIOR TO P	ELECTRICAL REQUIREM PROCEEDING.	IALL VERIFY EXACT LOCATION ENTS, OR TYPE OF CONNECTIO	N REQUIRED FOR ANY	EQUIPMENT SCHEDUL	LED ABOVE SHALL E	BE BROUGHT
							EQUIPMENT TERMINATION E	OX.		FINAL CONNECTION TO UNIT A				
MOUNTING HEIGHTS (DISTANCE FROM FINISHED FLOOR TO CEN	TER OF DEVICE UNLESS OTHERWISE NOT	TED)	EXISTI		<u>厂</u>	15KVA XFMR	CONDUIT AND BOXES REQU	·		STALLED IN SUCH A WAY AS	IS NUL GUVER UP EQ	WILNI NAMEPLATES	, JENVIUE AKEAS,	
RECEPTACLE		,	480V	/ SERVICE - · · · · · · · · · · · · · · · · · ·		Ч О О М	L							
GENERAL ABOVE COUNTER TOP	18" AFF. (UNLESS OTHERWISE NOTED 46" AFF. (UNLESS OTHERWISE NOTED			1 POWER RI						SHE	et title: SYMF	BOLS AND	SCHEDI	JI FS
LIGHT SWITCH	46" AFF. (UNLESS OTHERWISE NOTED	D)		E4 E1 NOT TO SCALE									DEPARTMENT OF T	THE NAVY
TELECOMMUNICATIONS GENERAL	18" AFF. (UNLESS OTHERWISE NOTED			NOTES:					WA	RD • GRIFFIN	LEY & SMITH ARCH BOX 518 SHELBY, M EAST MARION ST. SH	NC 28151-0518	MARIN	
ABOVE COUNTER TOP WALL	46" AFF. (UNLESS OTHERWISE NOTED 46" AFF.	D)				BREAKER IN SPACE AVAILABLE OF ER, FEDERAL PACIFIC CLASS 5320.			Char	ox 240826 • 4223 South Boulevard otte, NC 127-2112 MSWG# 12-014 DES. DR.	SWB SWB		REPAIR	
TELEVISION	18" AFF. (UNLESS OTHERWISE NOTED	D)								CHK CHK	MPA IITTED BY:		BUIL	DING AS
										E E C T TO DESI 12490	SN DIR.	DATE	SIZE CODE IDENT. N	

	SMADOL		REVISIONS ED EQUPIMENT SCHEDULE
Δ1	SYMBOLS	WIRING DEVICES	T-TRIP REVISIONS
	DESCRIPTION	SYMBOL DESCRIPTION	
-	CONDUIT RUN CONCEALED ABOVE CEILINGS OR IN WALLS.	DUPLEX RECEPTACLE, 125V, 3-WIRE GROUNDING TYPE.	
		SERVICE: 480V 3PH 3W MOUNTING: SURFACE	
	CONDUIT RUN CONCEALED IN OR BELOW FLOORS OR UNDERGROUND.	Image: Bubble with a construct a construct of the construction of the const	
	CONDUIT RUN EXPOSED.	CKT NEUT A B C CKT HWP-3 12 15/3 1A 0.4 Image: Comparison of the second	
	CONDUIT TURNING UP	\rightarrow GFI DUPLEX RECEPTACLE, GROUND FAULT CIRCUIT INTERROPTING.	
-•	CONDUIT TURNING DOWN	$ = \Theta_{WP} DUPLEX GFCI RECEPTACLE. PROVIDE WITH OPERABLE, IN-USE WEATHERPROOF COVER. $ $ = 12 7 5C 0.4 0.9 6C 7 12 12 12 12 12 12 12 $	
_	SQUARE ON CONDUIT SYMBOL INDICATES THAT CIRCUIT CONTINUES BUT NOT SWITCHLEG.	Θ_{C} DUPLEX RECEPTACLE, 125V, 5-WIRE GROUNDING TIPE. CEILING MOUNTED.	РН
•	HOMERUN TO PANEL AND CIRCUIT(S) DESIGNATED. ARROW(S) INDICATE QUANTITY OF CIRCUITS.	TWO DUPLEX RECEPTACLES, 125V, 3-WIRE GROUNDING TYPE, IN A TWO-GANG BOX WITH TWO-GANG FACEPLATE.	120V
	JUNCTION BOX PER N.E.C.	SPECIAL PURPOSE RECEPTACLE, WITH SPECIAL NEMA CONFIGURATION AS NOTED. 12 13 13 16B 12	
	SPECIAL NOTE, NUMERALS IDENTIFY, SEE SCHEDULE.	$\bigvee WALL OUTLET FOR TELECOMMUNICATIONS. SEE SPECIFICATIONS AND/OR DRAWINGS FOR$	
	SPECIAL CONNECTION TO A SPECIFIC ITEM OF EQUIPMENT. SEE CONNECTION SCHEDULE.	CONDUIT AND CABLING REQUIREMENTS.	
	MOTOR CONNECTION. RATING AS NOTED.	Image: Provide and the second state of the second stat	
		ASSOC	CONTACTS ATED WITH
١G			PPRESSION / DN SYSTEM -
	DESCRIPTION	S LIGHT SWITCH, 3-WAY, V V V V V V V V V V V V V V V V V V V	ST CBS
ו	FLUORESCENT LIGHTING FIXTURE, DRAWN TO SCALE.	S4 LIGHT SWITCH, 4-WAY, 7 336 0.0 7 336 7 336 9 0.0 </td <td>ST PAR</td>	ST PAR
ן נ 		SS WHERE TWO SWITCHES ARE SHOWN CONTROLLING A SINGLE OR COMMON GROUP OF FLUORESCENT LIGHTING FIXTURES, EACH WITH 3 OR MORE LAMPS, THE SWITCH CLOSEST TO	
	FLUORESCENT LIGHTING FIXTURE, CONNECTED TO AN EMERGENCY CIRCUIT (SWITCHED)	THE DOOR SHALL CONTROL THE INNER LAMP(S) IN EACH FIXTURE, AND THE OTHER SWITCH 7 398 0.0 408 7 6.0 408 7 6.0 408 7 6.0 408 7 6.0 408 7 6.0 408 7 6.0 408 7 6.0 408 7	ST PAN
]	FLUORESCENT LIGHTING FIXTURE, UTILIZED AS A NIGHT-LIGHT. CONNECT TO THE UNSWITCHED	BALLAST WIRING SHALL BE UTILIZED TO ACHIEVE THIS CONTROL.	
	LEG OF THE CIRCUIT.	ST PROGRAMMABLE LIGHT SWITCH, WALL MOUNTED.	SHUNT TRIP DEVICE
	FLUORESCENT LIGHTING FIXTURE, CONNECTED TO AN EMERGENCY CIRCUIT, CONNECT TO THE UNSWITCHED LEG OF THE CIRCUIT.	OS OCCUPANCY SENSOR, CEILING MOUNTED. PROVIDE WITH 10 FEET WHIP TO ALLOW FIELD	INDICATED
	BARE FLUORESCENT STRIP FIXTURE.		JNT-TRIP CONTRO
	BARE FLUORESCENT STRIP FIXTURE CONNECTED TO AN EMERGENCY CIRCUIT. CONNECT TO		O SCALE
	THE UNSWITCHED LEG OF THE CIRCUIT.		
	INCANDESCENT, HID OR COMPACT FLUORESCENT LIGHTING FIXTURE, CEILING MOUNTED.	ABBREVIATIONS	
	INCANDESCENT, HID OR COMPACT FLUORESCENT LIGHTING FIXTURE, CONNECTED TO AN	A AMPERES KW KILOWATTS	
	EMERGENCY CIRCUIT OR EMERGENCY BALLAST.	ACC ARMORED CLAD CABLE LFNC LIQUIDTIGHT FLEXIBLE NON-METALLIC CONDUIT AFF ABOVE FINISHED FLOOR LFMC LIQUIDTIGHT FLEXIBLE METALLIC CONDUIT	
	INCANDESCENT, HID OR COMPACT FLUORESCENT LIGHTING FIXTURE, WALL MOUNTED.	AFG ABOVE FINISHED GRADE LVC LOW VOLTAGE CONTROL CABINET	
	INCANDESCENT, HID OR COMPACT FLUORESCENT LIGHTING FIXTURE, WALL MOUNTED. CONNECTED TO AN EMERGENCY CIRCUIT OR EMERGENCY BALLAST.	ANN FIRE ALARM ANNUNCIATOR CABINET MCB MAIN CIRCUIT BREAKER C CONDUIT MCC METAL CLAD CABLE	
	EXIT SIGN CEILING MOUNTED SHADING INDICATES FACE ORIENTATION	CB CIRCUIT BREAKER MLO MAIN LUGS ONLY CKT CIRCUIT MTD MOUNTED ENCLOSED SWITCH AND CIRCUIT BREAKER S	
	CONNECT TO THE UNSWITCHED LEG OF THE CIRCUIT.	CLG CEILING NMC NON-METALLIC CLAD CABLE DN DOWN PB PULLBOX FB POLES FRAME/SWITCH TRIP/FUSE	SC RATING ENCLOSURE
	EXIT SIGN, WALL MOUNTED. SHADING INDICATES FACE ORIENTATION. BESIDE SYMBOL CONNECT TO THE UNSWITCHED LEG OF THE CIRCUIT.	DNDOWNDOWNPOLLBOXFOLLBOXFOLLBOXTMCB208Y/1203225A200ADWDISHWASHERPNLPANELBOARDFOLLBOXFOLLBOXFOLLBOXFOLLBOXFOLLBOX208Y/1203225A200AECEMPTY CONDUITPRSPROGRAM RAPID STARTFOLLBOXFOLLBOXFOLLBOXFOLLBOXFOLLBOX7MCB208Y/1203200AECEMPTY CONDUITPRSPROGRAM RAPID STARTFOLLBOXFOLLBOXFOLLBOXFOLLBOX600A600A	10 KAIC 1 10 KAIC 1
	EMERGENCY BATTERY PACK FIXTURE, CEILING MOUNTED. CONNECT TO UNSWITCHED LEG OF	EMT ELECTRICAL METALLIC TUBING PS PROGRAM START { CBSIM2 SIMULATOR ROOM 2 TMCB 480Y/277 3 400A 300A	25 KAIC 1
	THE CIRCUIT.	ENT ELECTRICAL NON-METALLIC TUBING PWR POWER EWC ELECTRIC WATER COOLER REC RECEPTACLE	
	EMERGENCY BATTERY PACK FIXTURE, WALL MOUNTED. CONNECT TO UNSWITCHED LEG OF THE CIRCUIT.	FACP FIRE ALARM CONTROL PANEL RMC RIGID METAL CONDUIT SYM. EQUIPMENT VOLT/ DISCONNECT FMC FLEXIBLE METAL CONDUIT RS RAPID START SYM. EQUIPMENT LOAD VOLT/ DISCONNECT	USE ENCLO. CONDUCTORS TYPE
 1115	ION	G GROUND SC FIRE ALARM PULL STATION GFI GROUND FAULT INTERRUPTER SW SWITCH (1) AHU-1 7.5HP 208/3 BUILT INTO VED BY DIVISION	
	DESCRIPTION	HOAHAND OFF AUTOMATICSWBDSWITCHBOARD2AHU-27.5HP480/3NFDS30A3HPHORSEPOWERTTBTELEPHONE TERMINAL BOARD3CRAC-123452ELA480/3EDS30A315A	1 3#10, 1#10G FMC
	ELECTRICAL PANELBOARD, FLUSH MOUNTED.	HPHORSEPOWERTIBTELEPHONETERMINAL BOARD③CRAC-1,2,3,45.2FLA480/3FDS30A315AHPFHIGH POWER FACTORTELTELEPHONETELEPHONETELEPHONE480/3FDS30A315AHXHIGH REACTANCETVTELEVISIONTELEVISION④CRAH-1,2,3,43.0HP, 25.0KW480/3NFDS100A3	3R 3#12, 1#12G LFMC 1 3#4, 1#8G FMC
	ELECTRICAL PANELBOARD, SURFACE MOUNTED.	IG ISOLATED GROUND TYP TYPICAL ISOLATED USER IN THE AUTOR INTERVALUE AUTOR IN THE AUTOR INTERVALUE AUTOR INTERVALUE AUTOR INTERVALUE AUTOR INTERVALUE AUTOR INTERVALUE AUTOR INTERVALUE AUTOR INTE	1 3#8, 1#10G FMC
	CONTROL CABINET, FLUSH OR SURFACE MOUNTED.	IMCINTERMEDIATE METAL CONDUITVVOLTSISINSTANT STARTVPVAPOR PROOF	1 3#10, 1#10G FMC
	MOTOR STARTER	JBJUNCTION BOXWWALL MOUNTED7CAH-1,25.0HP, 10KW480/3NFDS30A3KVAKILOVOLT-AMPERESWGWIRE GUARD(8)TEMPORARY A/C UNIT2@18.6RLA, 2@2.5FLA, 480/3NFDS100A370A	1 3#10, 1#10G FMC 3R 3#4, 1#8G LFMC
	ENCLOSED CIRCUIT BREAKER	FPN FUSE PER NAMEPLATE WP WEATHER PROOF 8 1Emporare A/C UNIT 36KW 480/3 NFDS 100A 3 70A XFMR TRANSFORMER 9 VF-2 0.75HP 480/3 NFDS 30A 3	1 3#12, 1#12G FMC
		Image: Second	
	DISCONNECT SWITCH, NON-FUSIBLE.	Image: Market big 1.05HP 480/3 BUILT INTO VARIABLE FREQUENCY	
	DISCONNECT SWITCH, FUSIBLE.	①CHWP-1,23.0HP480/3BUILT INTO VARIABLE FREQUENCY①CHWP-3,45.0HP480/3BUILT INTO VARIABLE FREQUENCY	
	DISCONNECT SWITCH PROVIDED WITH EQUIPMENT.	LEGEND	STARTER TYPES
	GROUND CONNECTION.	DISCONNECT TYPESDISCONNECT ENCLOSURE TYPESRACEWAY TYPESETCB = ELECTRONIC-TRIP CIRCUIT BREAKER1 = NEMA 1 ENCLOSUREEMT = ELECTRIC METALLIC TUEFDS = FUSIBLE DISCONNECT SWITCH3R = NEMA 3R ENCLOSUREFMC = FLEXIBLE METAL CONDUCT	ling
	COMBINATION MOTOR STARTER AND NON-FUSIBLE DISCONNECT SWITCH.	FDS = FUSIBLE DISCONNECT SWITCH3R = NEMA 3R ENCLOSUREFMC = FLEXIBLE METAL CONDUMCP = MOTOR CIRCUIT PROTECTOR4 = NEMA 4 ENCLOSUREIMC = INTERMEDIATE METAL CONDUNFDS = NON-FUSIBLE DISCONNECT SWITCH4X = NEMA 4X ENCLOSURELFMC = LIQUID-TIGHT FLEXIBLE	ONDUIT HOA = HAND-OFF-AUT
	COMBINATION MOTOR STARTER AND FUSIBLE DISCONNECT SWITCH.	ST/DS = COMBINATION STARTER/DISCONNECT SWITCH TMCB = THERMAL-MAGNETIC CIRCUIT BREAKER FPN = FUSE PER NAMEPLATE RMC = RIGID METAL CONDUIT	
	COMBINATION MOTOR STARTER AND CIRCUIT BREAKER.	TOG = HP RATED TOGGLE SWITCH	
	DRY-TYPE TRANSFORMER, 480-120/208V 3-PHASE OR 208-120/208V 3-PHASE.	EXISTING EXIST ALL ELECTRICAL CHARACTERISTICS SCHEDULED ABOVE ARE BASED ON INFORMATION AVAILABLE AT THE TIME OF DESIGN. ELECTRIC	
		ALL EQUIPMENT WITH EQUIPMENT SUPPLIER(S) PRIOR TO ROUGHING, AND SHALL VERIFY EXACT LOCATION AND EXACT TYPE OF CONNECTION REQUIRED FOR ANY E GROUNDED. ANY SIGNIFICANT CHANGES IN LOCATION, ELECTRICAL REQUIREMENTS, OR TYPE OF CONNECTION REQUIRED FOR ANY E	
		CONDUCTORS AND RACEWAY SPECIFIED IN THE ABOVE SCHEDULE ARE FOR FINAL CONNECTION TO UNIT AND SHALL BE EXTENDED	FROM THE DISCONNECT SHOWN ON THE FLOOR PI
	MOUNTING HEIGHTS	EQUIPMENT TERMINATION BOX.	MENT NAMEPLATES, SERVICE AREAS, AIR FLOW A
	(DISTANCE FROM FINISHED FLOOR TO CENTER OF DEVICE UNLESS OTHERWISE NO	EXISTING	
		480V SERVICE 4	
	RECEPTACLE GENERAL 18" AFF. (UNLESS OTHERWISE NOTI	D) PARTIAL PUMP ROOM SHEET TITLE:	
	ABOVE COUNTER TOP 46" AFF. (UNLESS OTHERWISE NOT	SIMB	OLS AND SCHEDULES
	LIGHT SWITCH 46" AFF. (UNLESS OTHERWISE NOT		
	<u>TELECOMMUNICATIONS</u> GENERAL 18" AFF. (UNLESS OTHERWISE NOTI	NOTES: WARD · GRIFFIN D)	28151-0518 MARINE C
	ABOVE COUNTER TOP 46" AFF. (UNLESS OTHERWISE NOT		
	WALL 46" AFF.		REPAIR FLIGHT
	TELEVISION 18" AFF. (UNLESS OTHERWISE NOTI	CHK. MPA	BUILDING AS CAMP LEJEUN
		DESIGN DIR.	
		12490 APPROVED:	DATE SIZE CODE IDENT. NO. NAVFAC

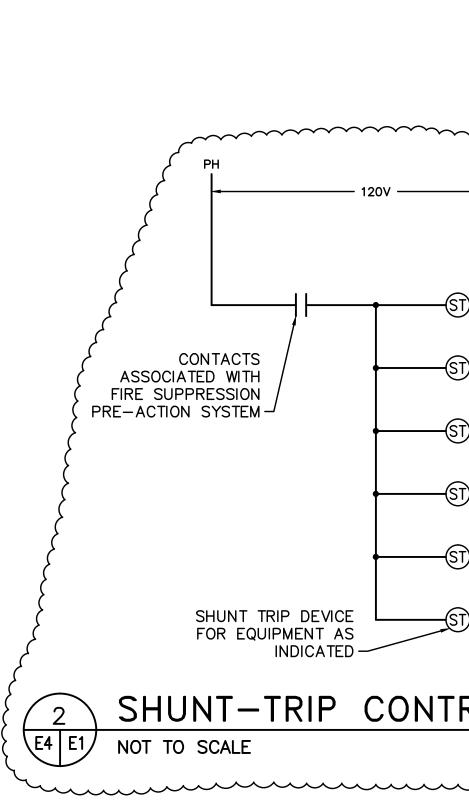



DATE SIZE CODE IDEN	. NO.	1
R0I	LDIN(camp	
REPAIR		
ARCHITECTURE INC. LBY, NC 28151-0518 ST. SHELBY, NC 28150	ΝE	-
YMBOLS AND SCHED	JLE	20


REV			
REV			
REV			
	ISIONS		DATE APPROVED
ULE			8/29/12
			9/5/12
\sim	~~~~	\sim	\sim
		N	λ
20V —			<pre></pre>
			2
•			
			ζ
			ź
	era	BCR2	ž
			\langle
<u>†</u>		BSIM2	Ş
			ζ
┥──	(ST)_	ANEL HR	$\mathbf{\hat{b}}$
	~ r		λ
			٢
	er P	ANEL CR	2
	\sim		\mathcal{L}
	STP	ANEL A	2
			<u>کر</u>
-		• •	٢
00	NTR	OL	DIAGRAM
			ا کر .
		. •	
~~~	$\cdots$		
~~~~	~~~~~	~~~~~	
			{
SURE		NOTES	}
			{
~~~		~~~~~	
	RACE	EWAY	
DRS	TYPE	SIZE	NOTES
	FMC	3/4"	
	FMC	1/2"	
	1 1010		
	LFMC	1/2"	
		1/2" 1–1/4"	
	LFMC	1-1/4"	
	LFMC FMC FMC	1-1/4" 3/4"	
	LFMC FMC	1-1/4" 3/4" 1/2"	
	LFMC FMC FMC FMC FMC	1-1/4" 3/4" 1/2" 1/2"	
	LFMC FMC FMC FMC FMC LFMC	1-1/4" 3/4" 1/2" 1/2" 1-1/4"	
	LFMC FMC FMC FMC FMC LFMC FMC	1-1/4" 3/4" 1/2" 1/2" 1-1/4" 1/2"	
	LFMC FMC FMC FMC FMC LFMC	1-1/4" 3/4" 1/2" 1/2" 1-1/4" 1/2" 1/2"	
	LFMC FMC FMC FMC FMC LFMC FMC	1-1/4" 3/4" 1/2" 1/2" 1-1/4" 1/2" 1/2" 1/2"	
	LFMC FMC FMC FMC FMC LFMC FMC	1-1/4" 3/4" 1/2" 1/2" 1-1/4" 1/2" 1/2" 1/2"	
	LFMC FMC FMC FMC LFMC FMC FMC FMC	1-1/4" 3/4" 1/2" 1/2" 1-1/4" 1/2" 1/2" 1/2"	
	LFMC FMC FMC FMC FMC FMC FMC FMC FMC FMC	1-1/4" 3/4" 1/2" 1/2" 1-1/4" 1/2" 1/2" 1/2" 1/2" 1/2"	
RTER_T = COW	LFMC FMC FMC FMC FMC FMC FMC FMC FMC FMC	1-1/4" 3/4" 1/2" 1/2" 1-1/4" 1/2" 1/2" 1/2" 1/2" 1/2"	AGE, NONREVERSING
= CON ITROL E	LFMC FMC FMC FMC FMC FMC FMC FMC FMC FMC	1-1/4" 3/4" 1/2" 1/2" 1-1/4" 1/2" 1/2" 1/2" 1/2" 1/2"	AGE, NONREVERSING
= COM <u>ITROL E</u> = HAN = RED	LFMC FMC FMC FMC FMC FMC FMC FMC FMC FMC	1-1/4" 3/4" 1/2" 1/2" 1/2" 1/2" 1/2" 1/2" 1/2" FULL VOLTA	
= COM ITROL D = HAN = RED = AUX	LFMC FMC FMC FMC FMC FMC FMC FMC FMC FMC	1-1/4" 3/4" 1/2" 1/2" 1/2" 1/2" 1/2" 1/2" 1/2" FULL VOLTA	N.O., 1 N.C.)
= COM ITROL D = HAN = RED = AUX	LFMC FMC FMC FMC FMC FMC FMC FMC FMC FMC	1-1/4" 3/4" 1/2" 1/2" 1/2" 1/2" 1/2" 1/2" 1/2" FULL VOLT, JTO HT NTACTS (2	N.O., 1 N.C.)
= COM ITROL D = HAN = RED = AUX	LFMC FMC FMC FMC FMC FMC FMC FMC FMC FMC	1-1/4" 3/4" 1/2" 1/2" 1/2" 1/2" 1/2" 1/2" 1/2" FULL VOLT, JTO HT NTACTS (2	N.O., 1 N.C.)
= COW $= HAN$ $= RED$ $= AUX$ $= 50$ $' ELECT$	LFMC FMC FMC FMC FMC FMC FMC FMC FMC FMC	1-1/4" 3/4" 1/2" 1/2" : N.O., 1 N.C.) ORMER 1CS OF
= COM = HAN = RED = AUX = 50	LFMC FMC FMC FMC FMC FMC FMC FMC FMC FMC	1-1/4" 3/4" 1/2" 1/2" 1/2" 1/2" 1/2" 1/2" 1/2" 1/2" FULL VOLT TACTS (2 DL TRANSF ARACTERIST AND SECUE	: N.O., 1 N.C.) ORMER 1CS OF
= COM = HAN = RED = AUX = 50 C ELECT L BE F SHALL E	LFMC FMC FMC FMC FMC FMC FMC FMC FMC FMC	1-1/4" 3/4" 1/2" 1/2" 1/2" 1/2" 1/2" 1/2" 1/2" 1/2" 1/2" 1/2" FULL VOLT, JTO HT NTACTS (2 DL TRANSFINATION THE ARACTERIST AND SECUR	N.O., 1 N.C.) ORMER ICS OF RELY
= COM = HAN = RED = AUX = 50	LFMC FMC FMC FMC FMC FMC FMC FMC FMC FMC	1-1/4" 3/4" 1/2" 1/2" 1/2" 1/2" 1/2" 1/2" 1/2" 1/2" FULL VOLT TACTS (2 DL TRANSF ARACTERIST AND SECUE	N.O., 1 N.C.) ORMER ICS OF RELY
= COM = HAN = RED = AUX = 50 Y ELECT L BE F SHALL E	LFMC FMC FMC FMC FMC FMC FMC FMC FMC FMC	1-1/4" 3/4" 1/2" 1/2" 1/2" 1/2" 1/2" 1/2" 1/2" 1/2" 1/2" 1/2" FULL VOLT, JTO HT NTACTS (2 DL TRANSFINATION THE ARACTERIST AND SECUR	N.O., 1 N.C.) ORMER ICS OF RELY THE
= COM = HAN = RED = AUX = 50 Y ELECT L BE F SHALL E	LFMC FMC FMC FMC FMC FMC FMC FMC FMC FMC	1-1/4" 3/4" 1/2" 1/2" 1/2" 1/2" 1/2" 1/2" 1/2" 1/2" 1/2" FULL VOLT, JTO HT NTACTS (2 DL TRANSFINATION RACTERIST AND SECUR IT TO THE PLANS TO	N.O., 1 N.C.) ORMER ICS OF RELY THE
= COM = HAN = RED = AUX = 50 C ELECT L BE F SHALL E	LFMC FMC FMC FMC FMC FMC FMC FMC FMC FMC	1-1/4" 3/4" 1/2" 1/2" 1/2" 1/2" 1/2" 1/2" 1/2" 1/2" 1/2" FULL VOLT, JTO HT NTACTS (2 DL TRANSFINATION RACTERIST AND SECUR IT TO THE PLANS TO	N.O., 1 N.C.) ORMER ICS OF RELY THE
= COM = HAN = RED = AUX = 50 C ELECT L BE F SHALL E N ON TH AREAS,	LFMC FMC FMC FMC FMC FMC FMC FMC FMC FMC	1-1/4" 3/4" 1/2" 1/2" 1/2" 1/2" 1/2" 1/2" 1/2" 1/2" 1/2" FULL VOLT, JTO HT NTACTS (2 DL TRANSFINATION RACTERIST AND SECUR IT TO THE PLANS TO	N.O., 1 N.C.) ORMER ICS OF RELY THE
= COM = HAN = RED = AUX = 50 C ELECT L BE F SHALL E N ON TH AREAS,	LFMC FMC FMC FMC FMC FMC FMC FMC FMC FMC	1-1/4" 3/4" 1/2" 1/2" 1/2" 1/2" 1/2" 1/2" 1/2" 1/2" 1/2" FULL VOLT, JTO HT NTACTS (2 DL TRANSFINATION RACTERIST AND SECUR IT TO THE PLANS TO	N.O., 1 N.C.) ORMER ICS OF RELY THE
= COM = HAN = RED = AUX = 50 C ELECT L BE F SHALL E N ON TH AREAS, - DU	LFMC FMC FMC FMC FMC FMC FMC FMC FMC FMC	1-1/4" 3/4" 1/2" 1/2" 1/2" 1/2" 1/2" 1/2" 1/2" 1/2" 1/2" FULL VOLT/ JTO HT NTACTS (2 DL TRANSF AND SECUE IT TO THE PLANS TO AREAS, ET	N.O., 1 N.C.) ORMER ICS OF RELY THE
= COM = HAN = RED = AUX = 50 ( ELECT L BE F SHALL E N ON TH AREAS, 	LFMC FMC FMC FMC FMC FMC FMC FMC	1-1/4" 3/4" 1/2" 1/2" 1/2" 1/2" 1/2" 1/2" 1/2" 1/2" 1/2" 1/2" FULL VOLT, NTACTS (2 DL TRANSF RACTERIST AND SECUE IT TO THE PLANS TO AREAS, ET NAVAL COR	E N.O., 1 N.C.) ORMER TICS OF RELY THE TC. E
= COM = HAN = RED = AUX = 50 ( ELECT L BE F SHALL E N ON TH AREAS, 	LFMC FMC FMC FMC FMC FMC FMC FMC	1-1/4" 3/4" 1/2" 1/2" 1/2" 1/2" 1/2" 1/2" 1/2" 1/2" 1/2" 1/2" FULL VOLT, NTACTS (2 DL TRANSF RACTERIST AND SECUE IT TO THE PLANS TO AREAS, ET NAVAL COR	E N.O., 1 N.C.) ORMER TICS OF RELY THE TC. E — 1
= COM = HAN = RED = AUX = 50 C ELECT L BE F SHALL E N ON TH AREAS, - DU - DU - DU - CAMP	LFMC FMC FMC FMC FMC FMC FMC FMC FMC FMC	1-1/4" 3/4" 1/2" 1/2" 1/2" 1/2" 1/2" 1/2" 1/2" 1/2" 1/2" 1/2" FULL VOLT, JTO HT NTACTS (2 DL TRANSFINATION AREAS, ET PLANS TO AREAS, ET NAVAL COR NE, NOR	E N.O., 1 N.C.) ORMER ICS OF RELY THE TC. E
E COM E HAN E RED E AUX E SO C ELECT E DU C ELECT E DU AREAS, E DU C AMP PAIR	LFMC FMC FMC FMC FMC FMC FMC FMC FMC FMC	1-1/4" 3/4" 1/2" 1/2" 1/2" 1/2" 1/2" 1/2" 1/2" 1/2" 1/2" 1/2" 1/2" FULL VOLT, JTO HT NTACTS (2 DL TRANSFI ARACTERIST AND SECUE IT TO THE PLANS TO AREAS, ET PLANS TO AREAS, ET SIMUL	EN.O., 1 N.C.) ORMER ICS OF RELY THE TC. E
= COM $= COM$ $= HAN$ $= RED$ $= AUX$ $= 50$ $C ELECT$ $E E F$ $C ELECT$ $E E F$ $C ELECT$ $C$	LFMC FMC FMC FMC FMC FMC FMC FMC FMC FMC	1-1/4" 3/4" 1/2" 1/2" 1/2" 1/2" 1/2" 1/2" 1/2" 1/2" 1/2" 1/2" FULL VOLT, JTO HT NTACTS (2 DL TRANSF AND SECUE IT TO THE PLANS TO AREAS, ET NAVAL COR NE, NOR SIMUI S320,	EN.O., 1 N.C.) ORMER TICS OF RELY THE TC. E
= COM $= COM$ $= HAN$ $= RED$ $= AUX$ $= 50$ $C ELECT$ $E E F$ $C ELECT$ $E E F$ $C ELECT$ $C$	LFMC FMC FMC FMC FMC FMC FMC FMC FMC FMC	1-1/4" 3/4" 1/2" 1/2" 1/2" 1/2" 1/2" 1/2" 1/2" 1/2" 1/2" 1/2" FULL VOLT, JTO HT NTACTS (2 DL TRANSF AND SECUE IT TO THE PLANS TO AREAS, ET NAVAL COR NE, NOR SIMUI S320,	EN.O., 1 N.C.) ORMER ICS OF RELY THE TC. E
= COM $= COM$ $= HAN$ $= RED$ $= AUX$ $= 50$ $C ELECT$ $E E F$ $C ELECT$ $E E F$ $C ELECT$ $C$	LFMC FMC FMC FMC FMC FMC FMC FMC FMC FMC	1-1/4" 3/4" 1/2" 1/2" 1/2" 1/2" 1/2" 1/2" 1/2" 1/2" 1/2" 1/2" 1/2" FULL VOLT, JTO HT NTACTS (2 DL TRANSF AND SECUE IT TO THE PLANS TO AREAS, ET PLANS TO AREAS, ET SIMUL SJ2O, JNE, NOR AC DRAWING	AND, 1 N.C.) ORMER ICS OF RELY THE TC. FACILITIES ENGINEERING COMMAND PSBASE TH CAROLINA LATOR FACILITY MCB, CLNC TH CAROLINA NO.
ELECT CAMP CAMP LFMC FMC FMC FMC FMC FMC FMC FMC FMC FMC	1-1/4" 3/4" 1/2" 1/2" 1/2" 1/2" 1/2" 1/2" 1/2" 1/2" 1/2" 1/2" 1/2" FULL VOLT, JTO HT NTACTS (2 DL TRANSF AND SECUE IT TO THE PLANS TO AREAS, ET PLANS TO AREAS, ET SIMUL SJ2O, JNE, NOR AC DRAWING	ANDOR 1 N.C.) ORMER ICS OF RELY THE TC. E — 1 FACILITIES ENGINEERING COMMAND PS BASE TH CAROLINA LATOR FACILITY MCB, CLNC TH CAROLINA
ELECT CAMP CAMP CAMP CAMP CAMP CAMP CAMP CAMP CAMP CAMP CAMP CAMP CAMP CAMP CAMP CAMP CAMP CAMP CAMP	LFMC FMC FMC FMC FMC FMC FMC FMC	1-1/4" 3/4" 1/2" 1/2" 1/2" 1/2" 1/2" 1/2" 1/2" 1/2" 1/2" 1/2" FULL VOLT, JTO HT NTACTS (2 DL TRANSFI AND SECUE IT TO THE PLANS TO AREAS, ET PLANS TO AREAS, ET SIMUL SJ20, JNE, NOR AC DRAWING T. CONTR. NO	EN.O., 1 N.C.) ORMER ICS OF RELY THE T. FACILITIES ENGINEERING COMMAND PSBASE TH CAROLINA LATOR FACILITY MCB, CLNC TH CAROLINA NO. 60010512 D. N40085-11-B-0207
ELECT CAMP CAMP CAMP CAMP CAMP CAMP CAMP CAMP CAMP CAMP CAMP CAMP CAMP CAMP CAMP CAMP CAMP CAMP CAMP	LFMC FMC FMC FMC FMC FMC FMC FMC	1-1/4" 3/4" 1/2" 1/2" 1/2" 1/2" 1/2" 1/2" 1/2" 1/2" 1/2" 1/2" 1/2" FULL VOLT, JTO HT NTACTS (2 DL TRANSF AND SECUE IT TO THE PLANS TO AREAS, ET NAVAL COR NE, NOR AC DRAWING	EN.O., 1 N.C.) ORMER ICS OF RELY THE T. FACILITIES ENGINEERING COMMAND PSBASE TH CAROLINA LATOR FACILITY MCB, CLNC TH CAROLINA NO. 60010512 D. N40085-11-B-0207
ELECT CAMP AIR CAMP AIR CAMP AIR CAMP AIR CAMP AIR CAMP AIR CAMP AIR CAMP	LFMC FMC FMC FMC FMC FMC FMC FMC	1-1/4" 3/4" 1/2" 1/2" 1/2" 1/2" 1/2" 1/2" 1/2" 1/2" 1/2" 1/2" FULL VOLT, JTO HT NTACTS (2 DL TRANSFI AND SECUE IT TO THE PLANS TO AREAS, ET PLANS TO AREAS, ET SIMUL SJ20, JNE, NOR AC DRAWING T. CONTR. NO	EN.O., 1 N.C.) ORMER ICS OF RELY THE T. FACILITIES ENGINEERING COMMAND PSBASE TH CAROLINA LATOR FACILITY MCB, CLNC TH CAROLINA NO. 60010512 D. N40085-11-B-0207

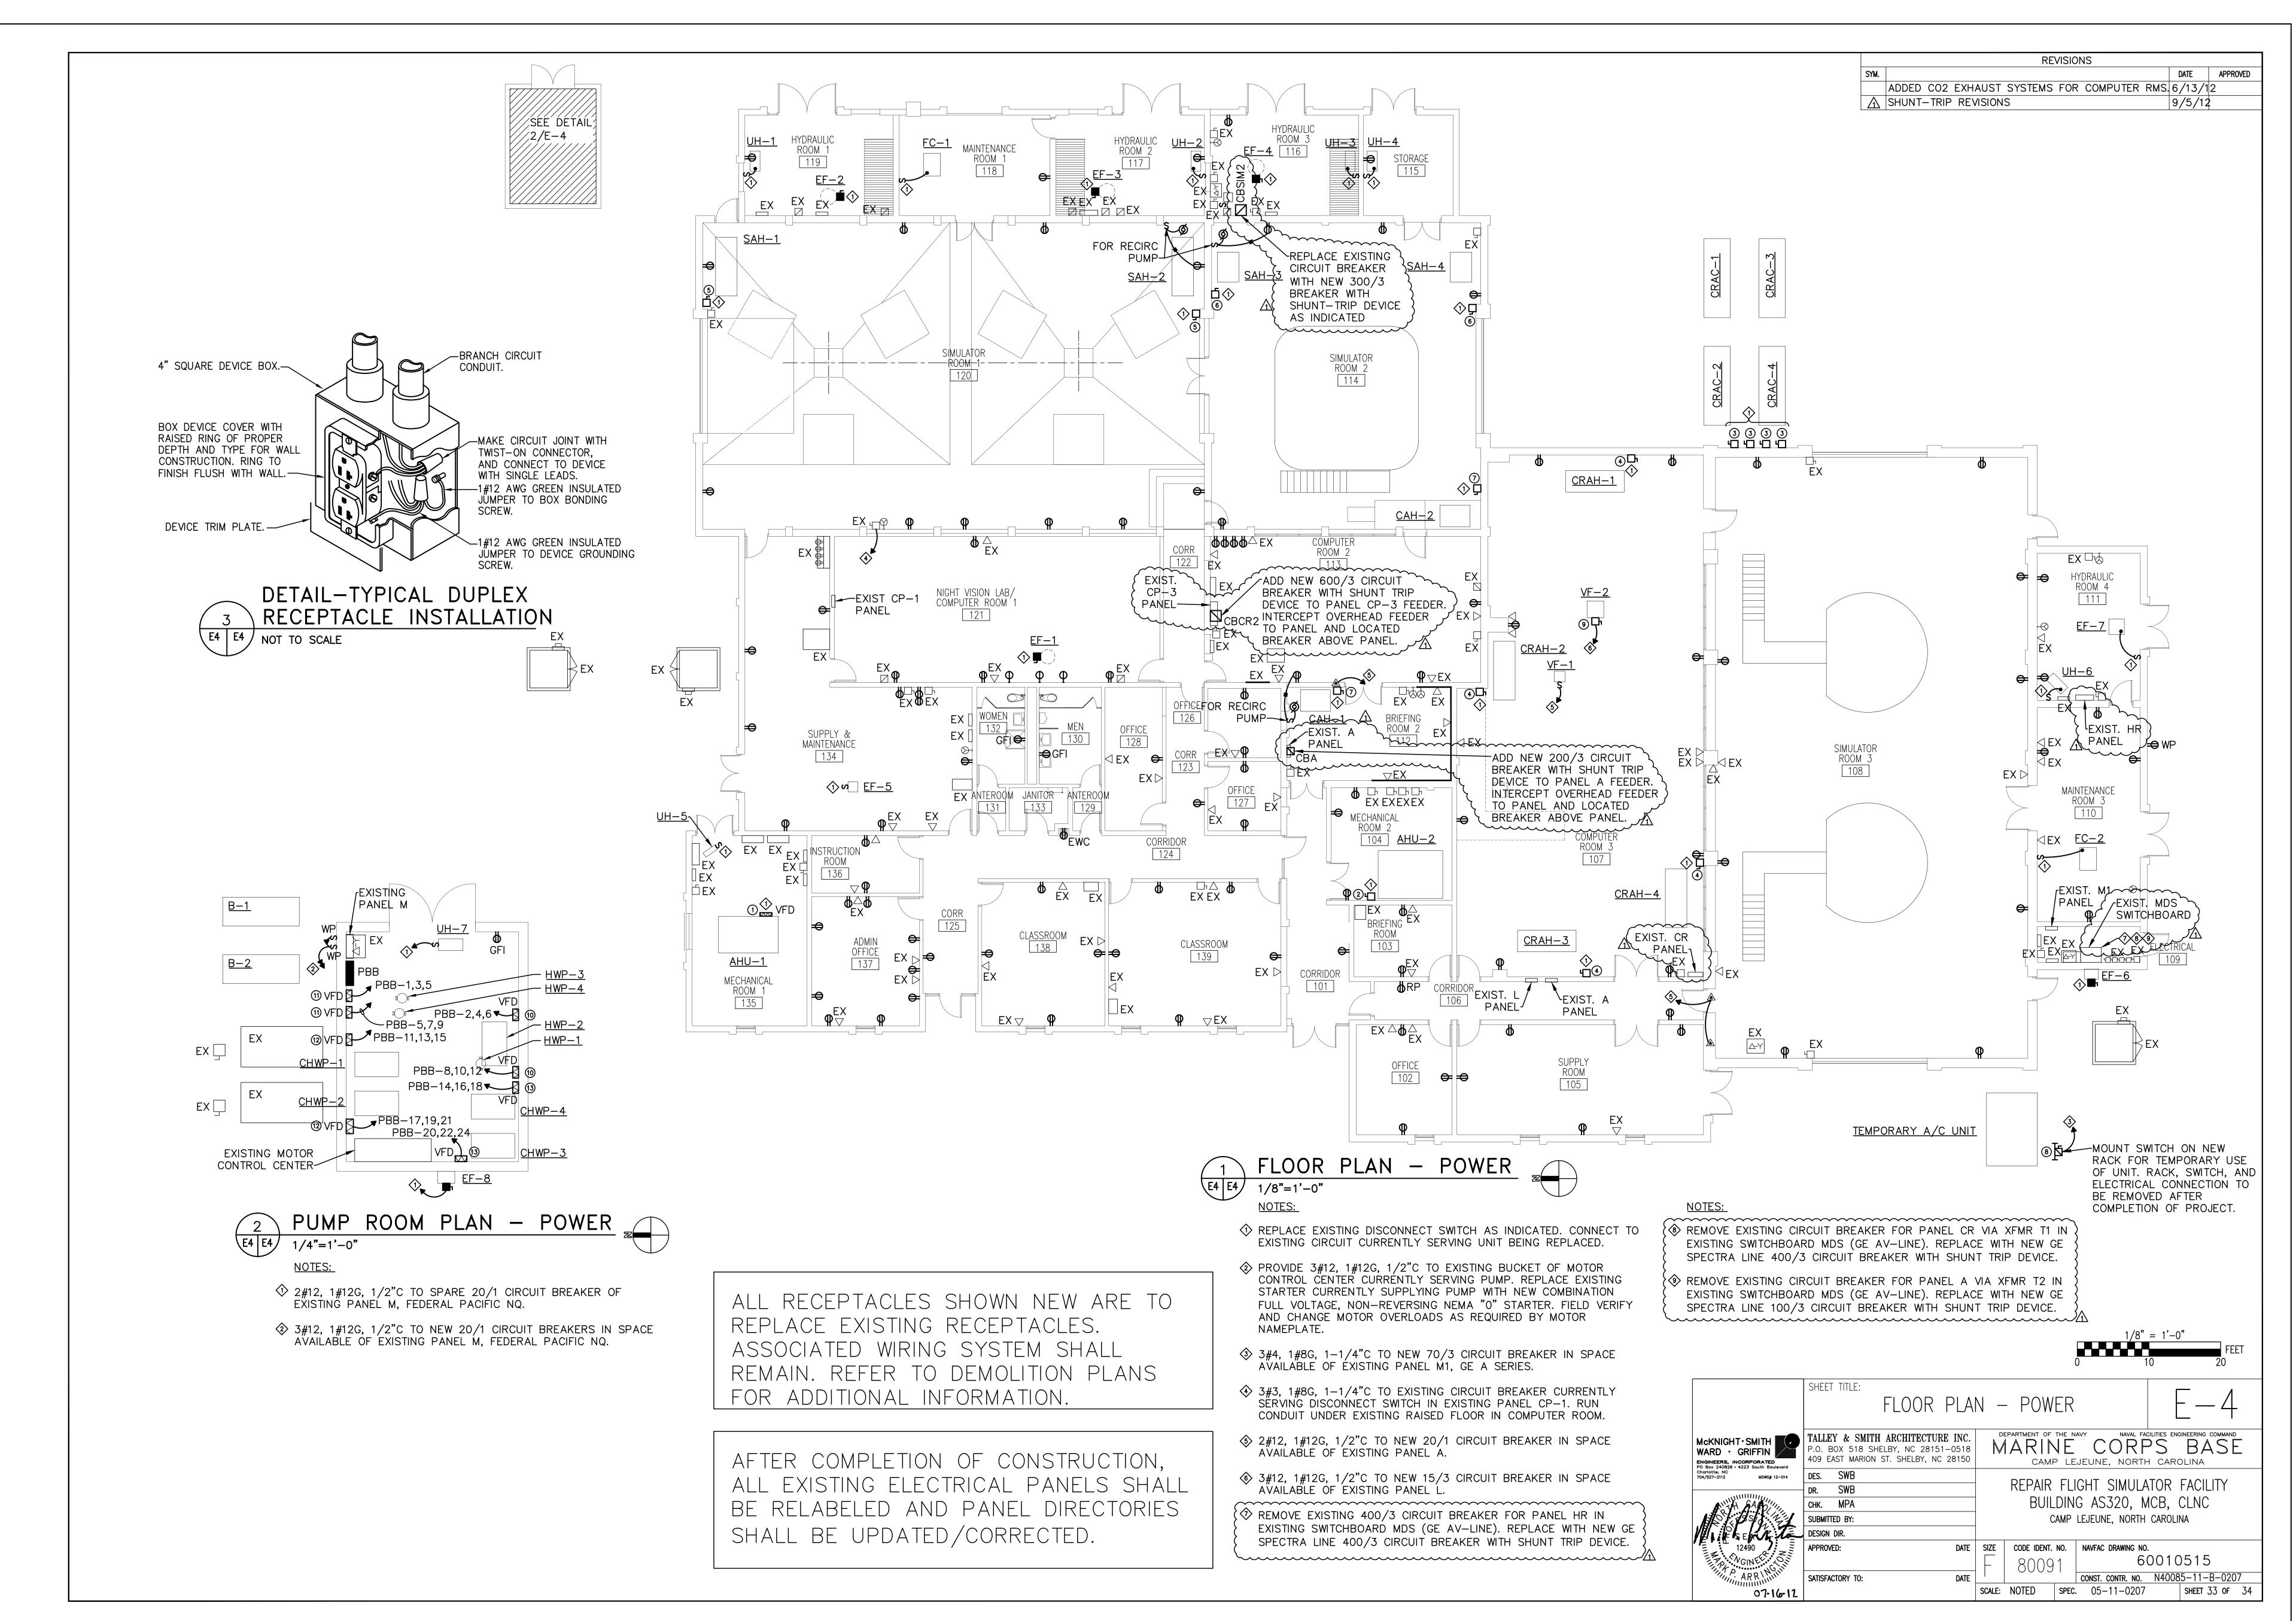

LEGEND	PRE-ACTION SY PRE-ACTION SY
POINT OF CONNECTION TO EXISTING	CO₂ HOSE REEL
	CO ₂ SYS
	CO ₂ SYS
	CO₂ SYS PRE-ACTION SY
	PRE-ACTION SY

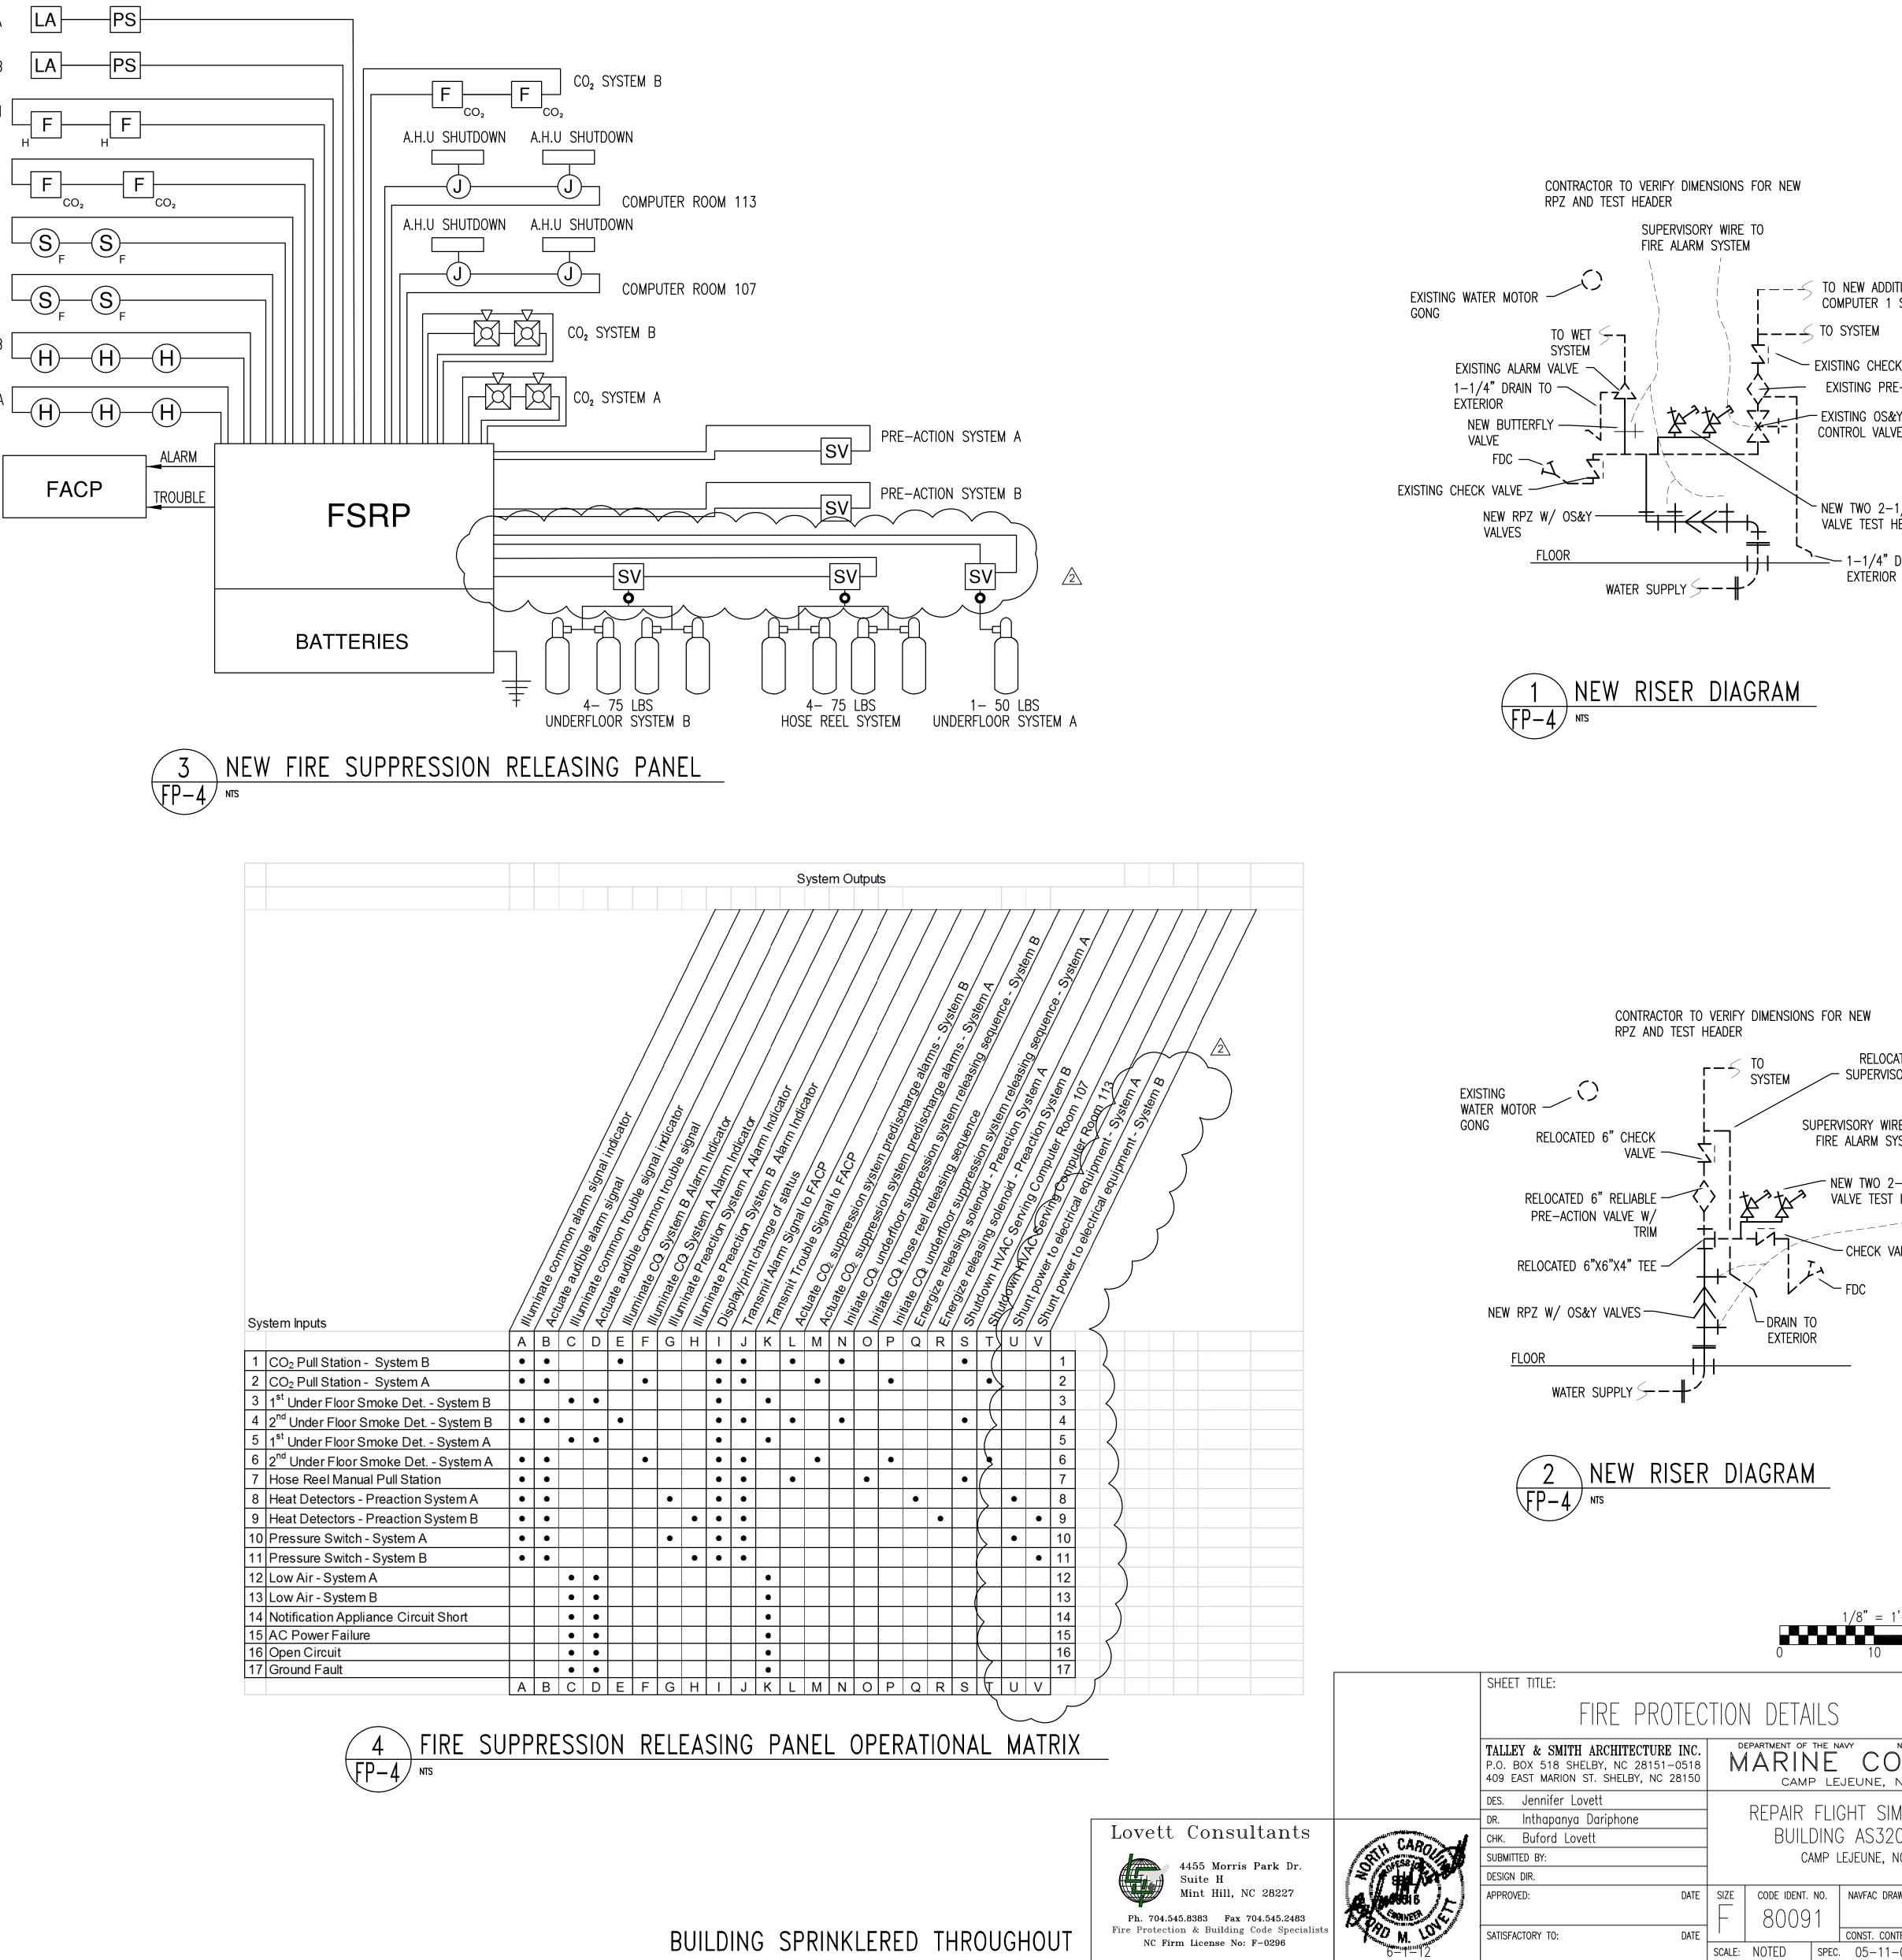

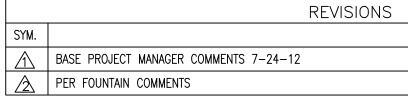

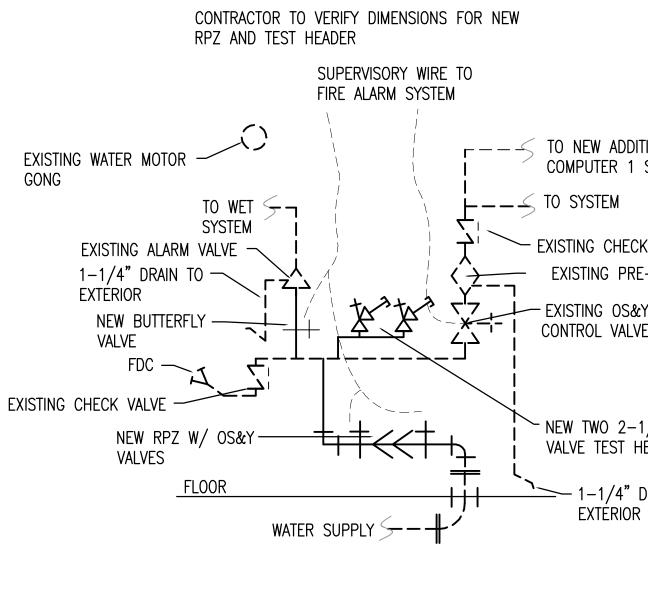

	DATE 7-27-12 8-29-12	APPROVED BML JLL
ITION & ADDI SYSTEM CK VALVE E-ACTION VALVE &Y VE	TION	
1/2" ANGLE HEADERS DRAIN TO R		
ATED 2" DRA Sory Air Pri AS RE TO YSTEM 2-1/2" ANGL HEADERS /ALVE	ESSURE SEMBLY	
1'-0"	FEET	N
NAVAL FACILITIES		COMMAND SE
MULATOR 20, MCB, NORTH CARO	CLNC	ΤΥ
<u>ntr. no. N400</u> –0207		